




SITE PLAN
SCALE: 1"=50'-0"

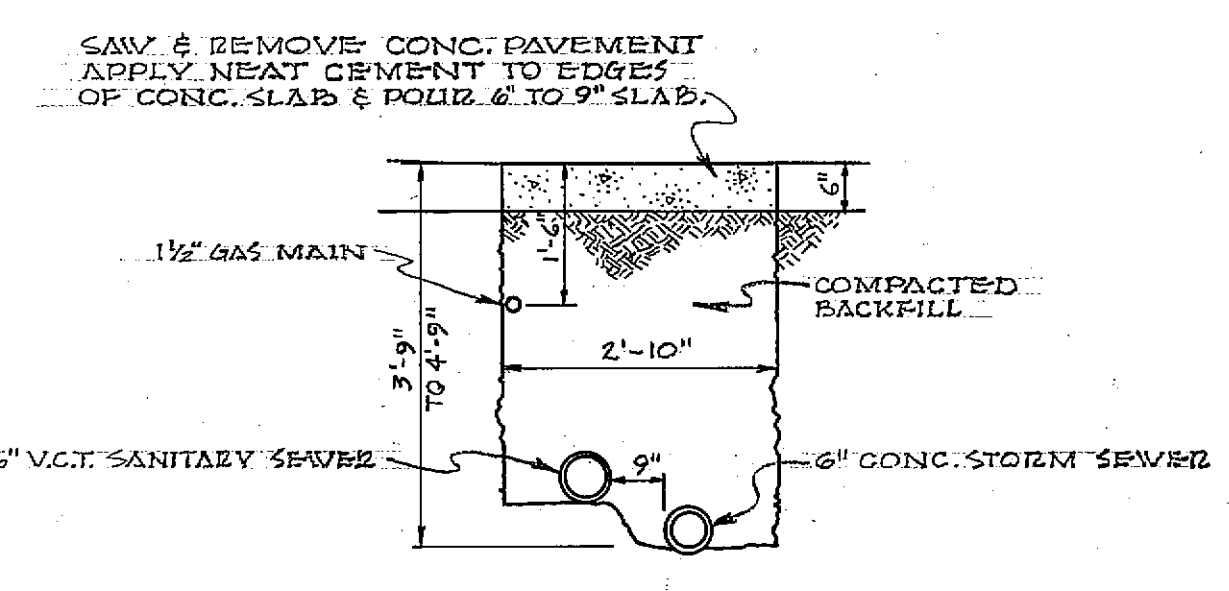


SECTION "AA"
SCALE: 1/2"=1'-0"

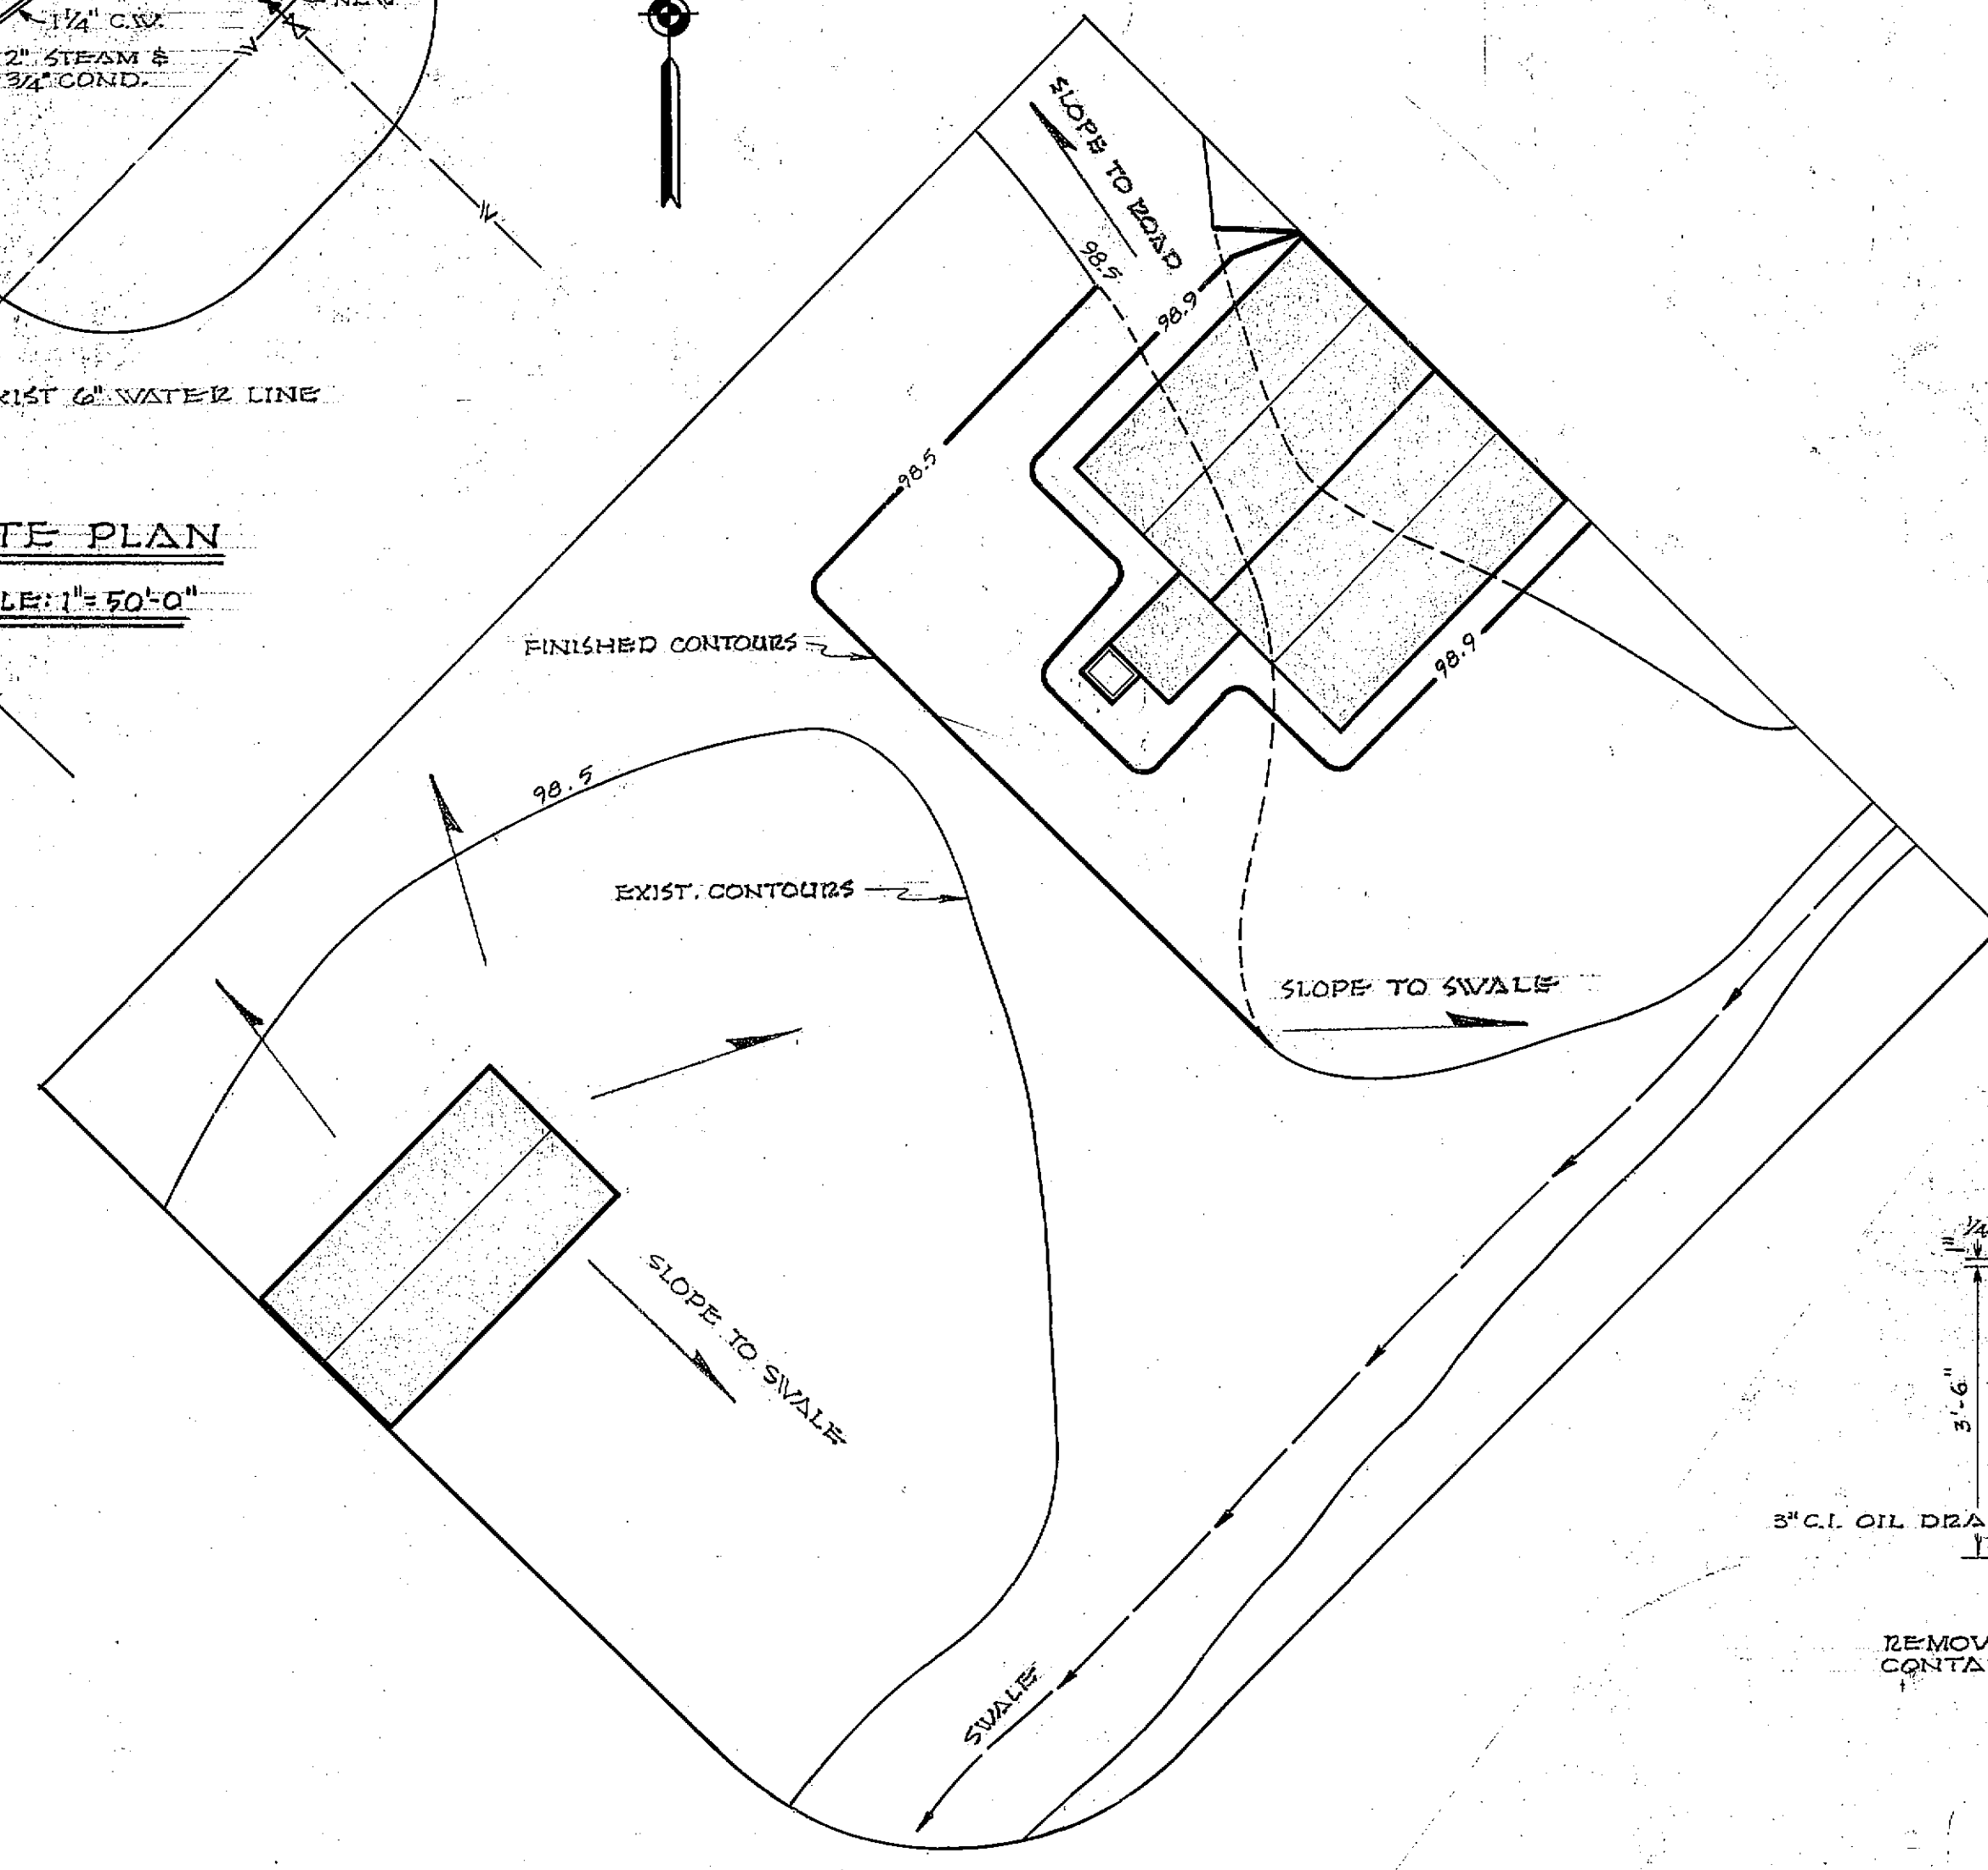


GRADING PLAN
SCALE: 1"=20'-0"

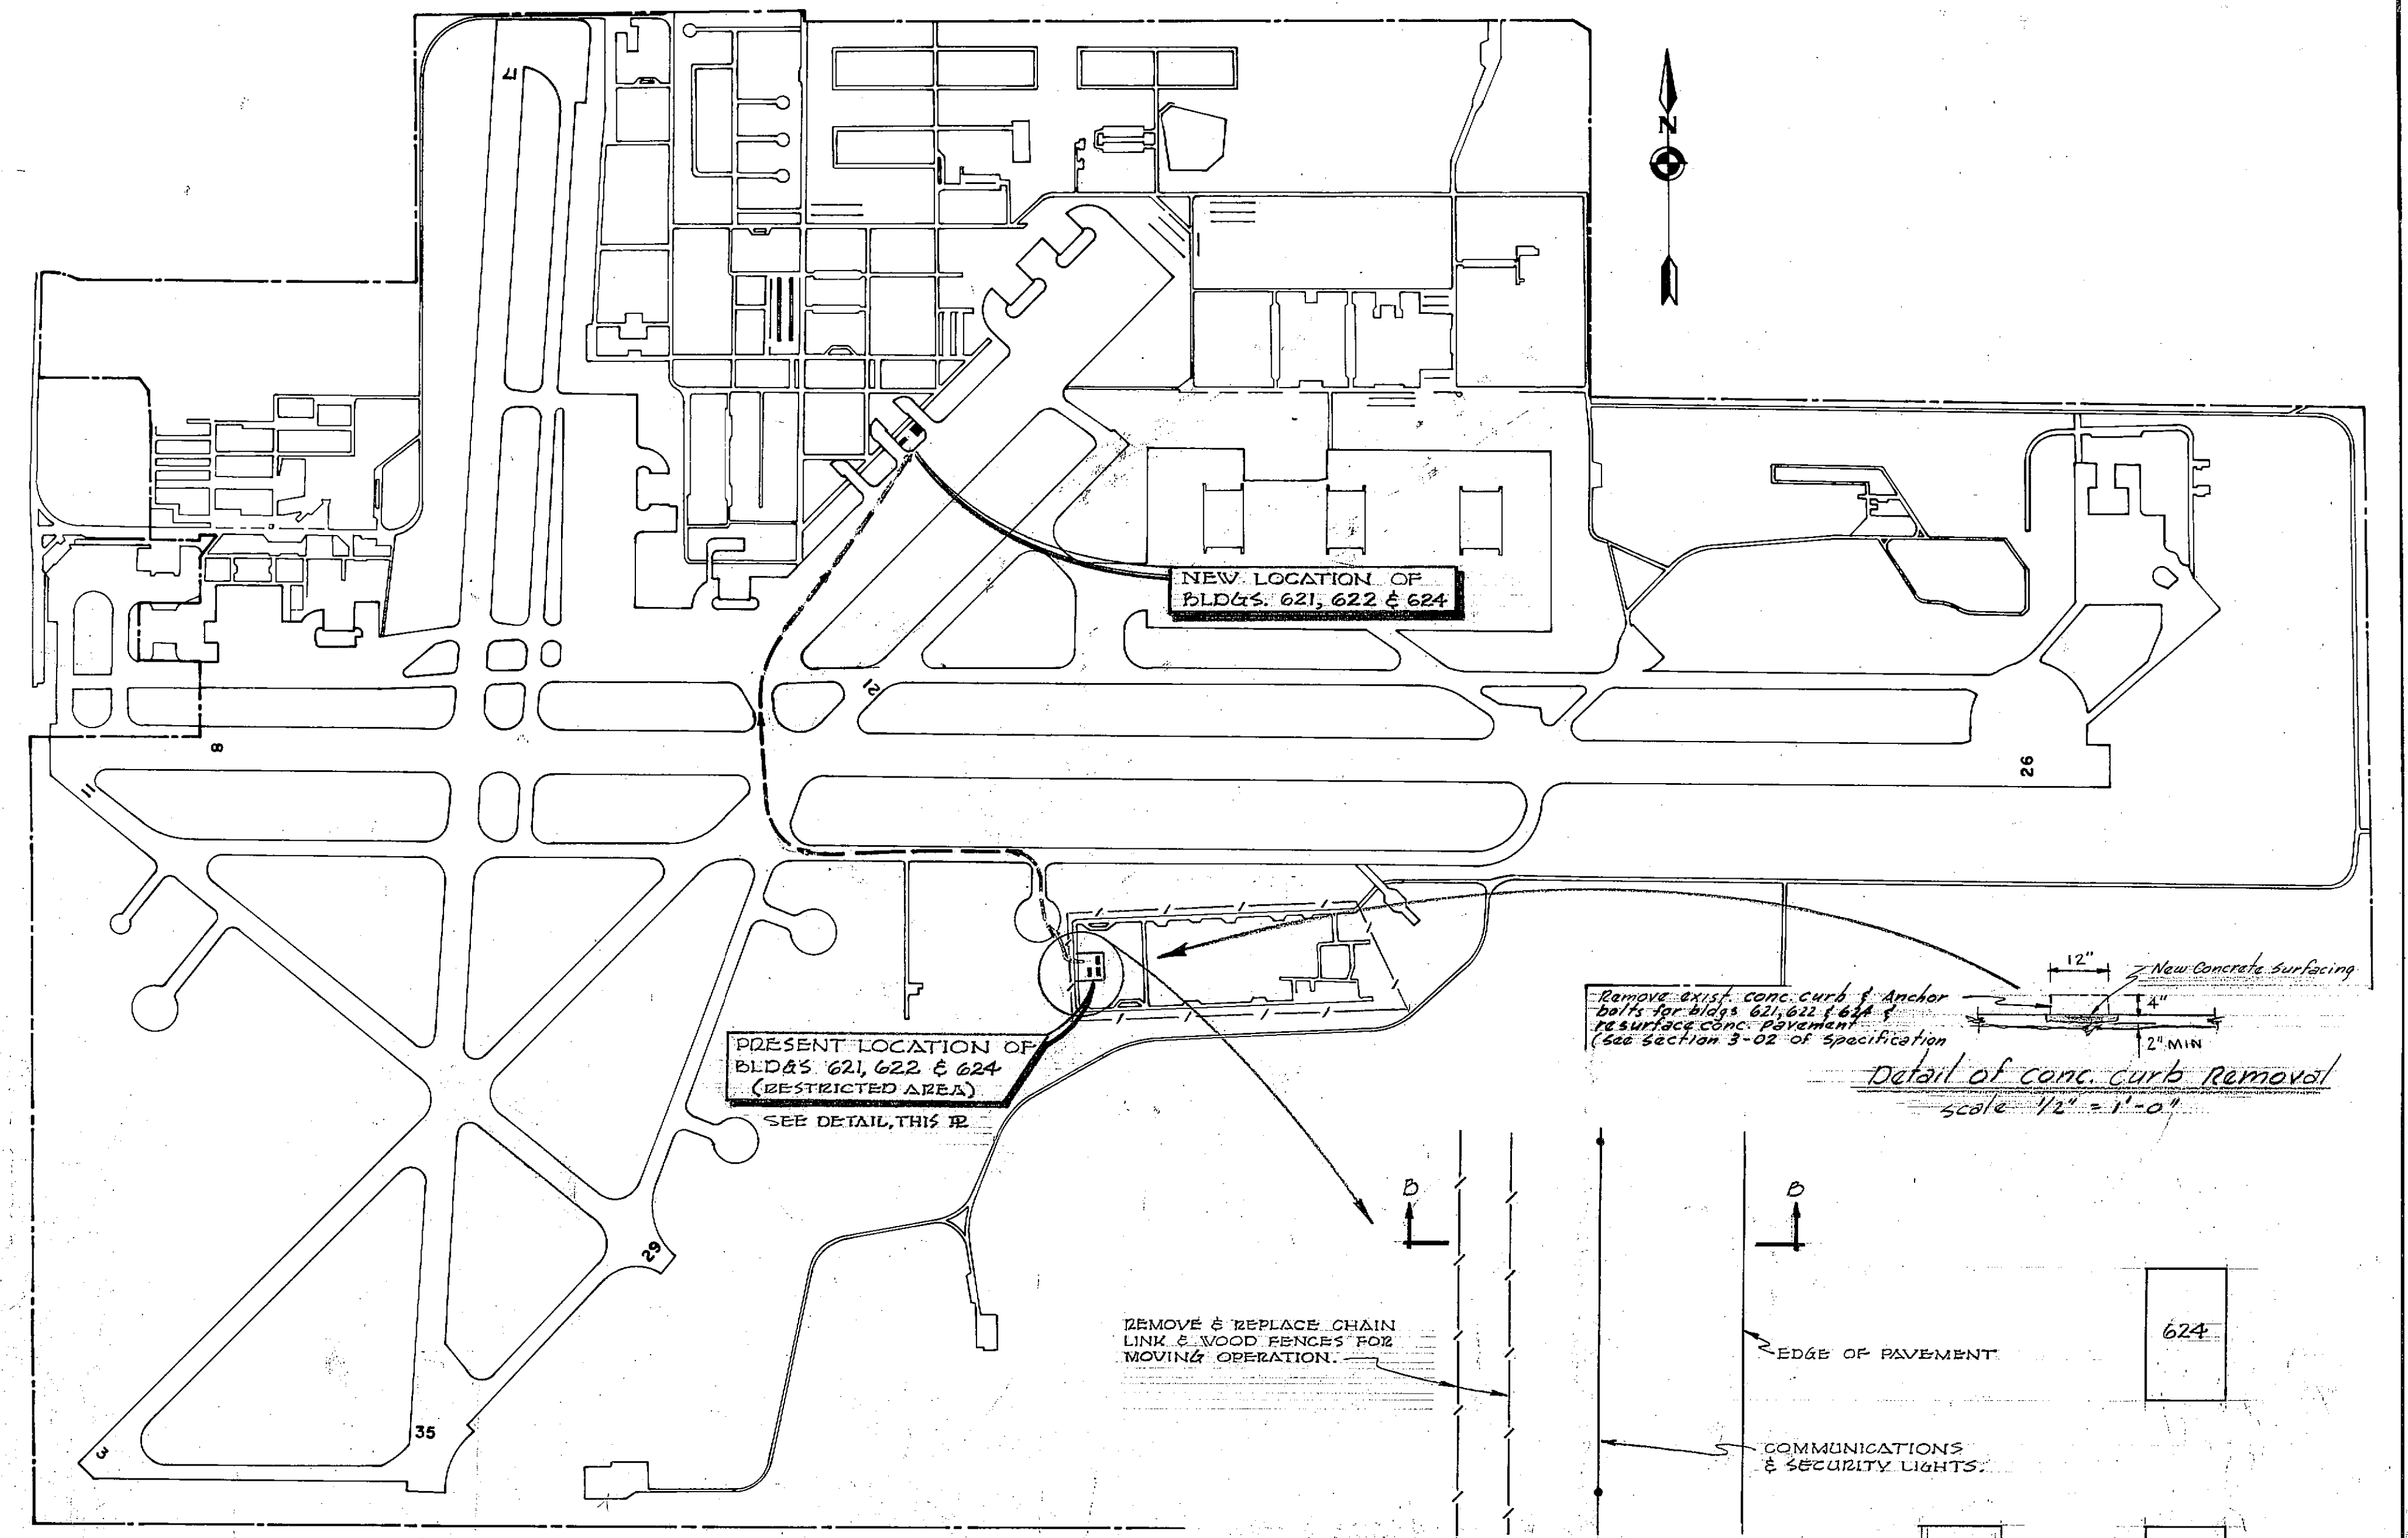


LOCATION PLAN
SCALE: 1"=800'

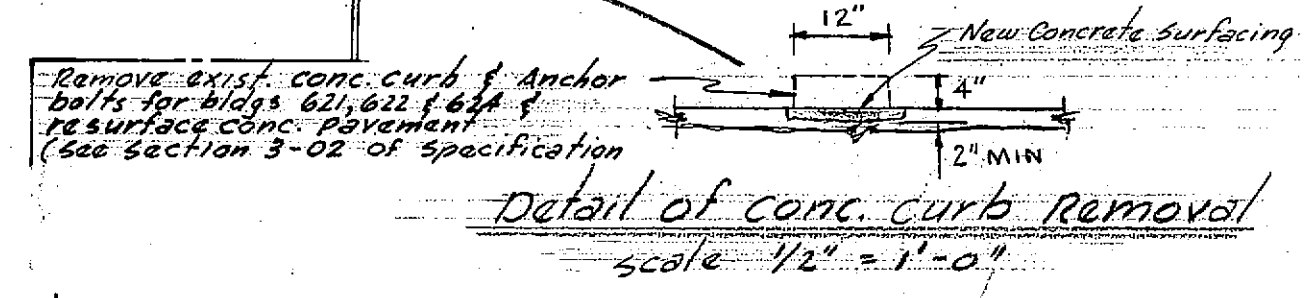


Detail of conc. curb Removal
SCALE: 1/2"=1'-0"

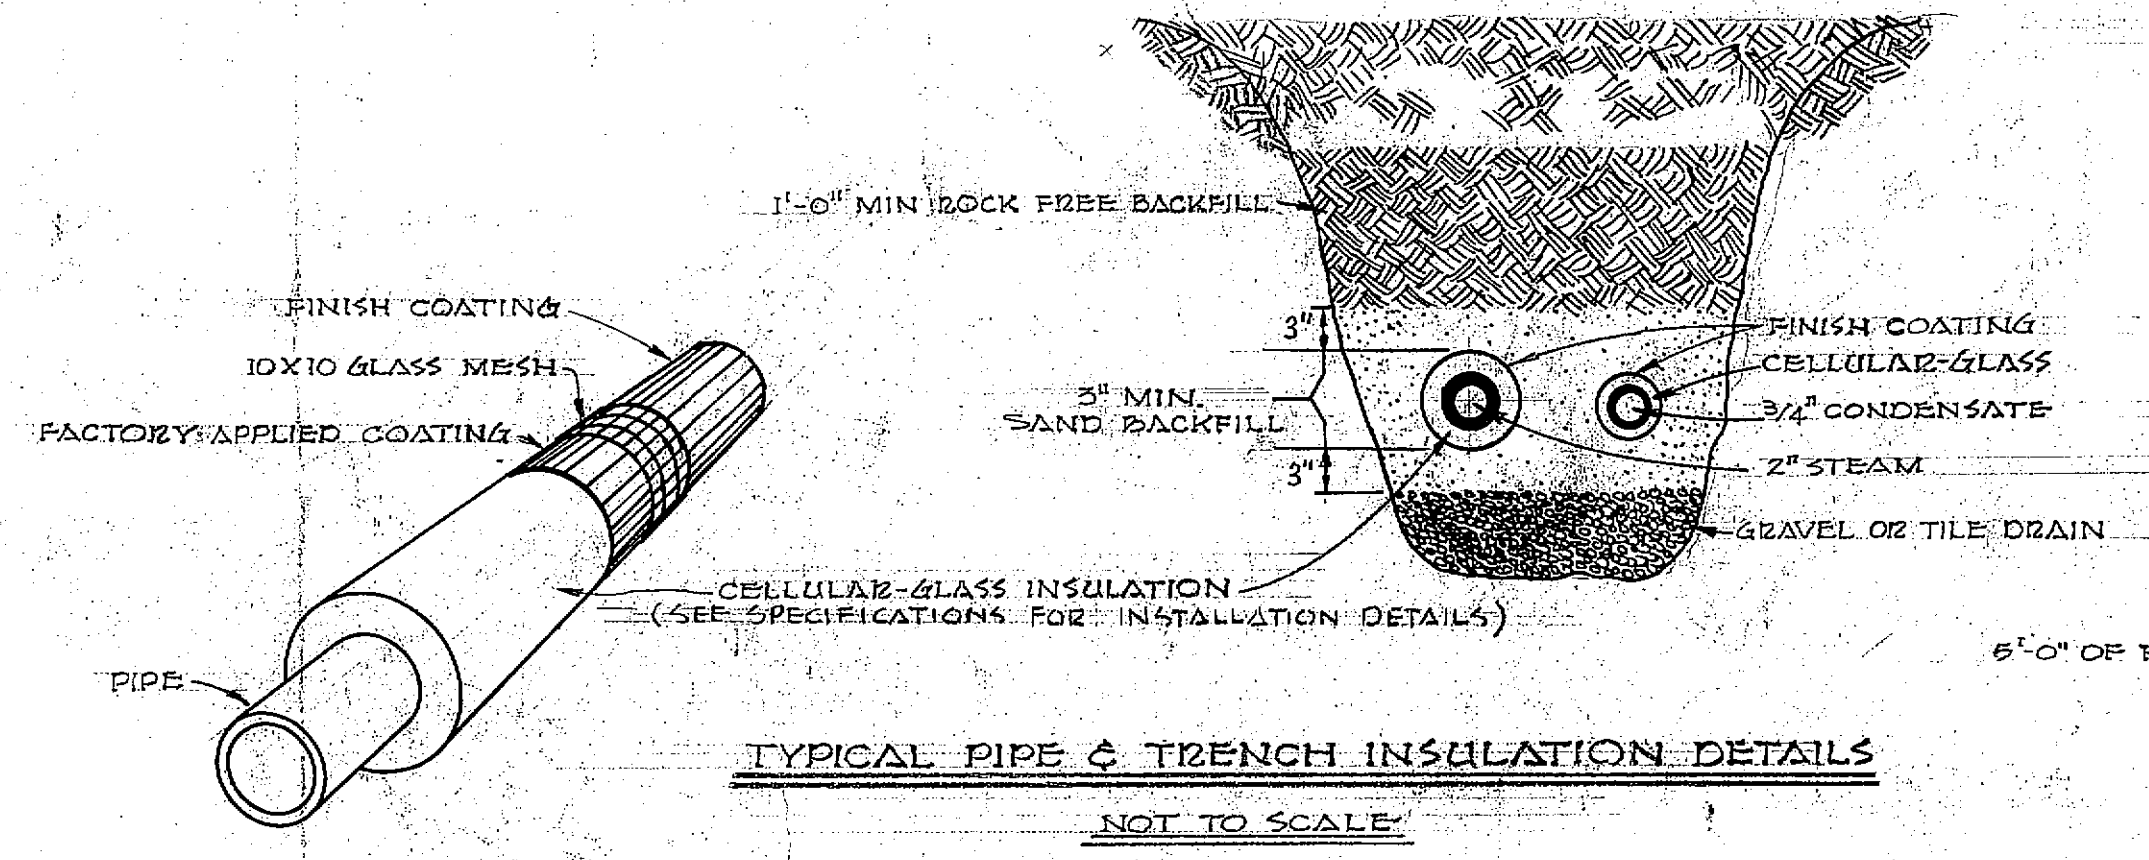

TYPICAL PIPE & TRENCH INSULATION DETAILS
NOT TO SCALE

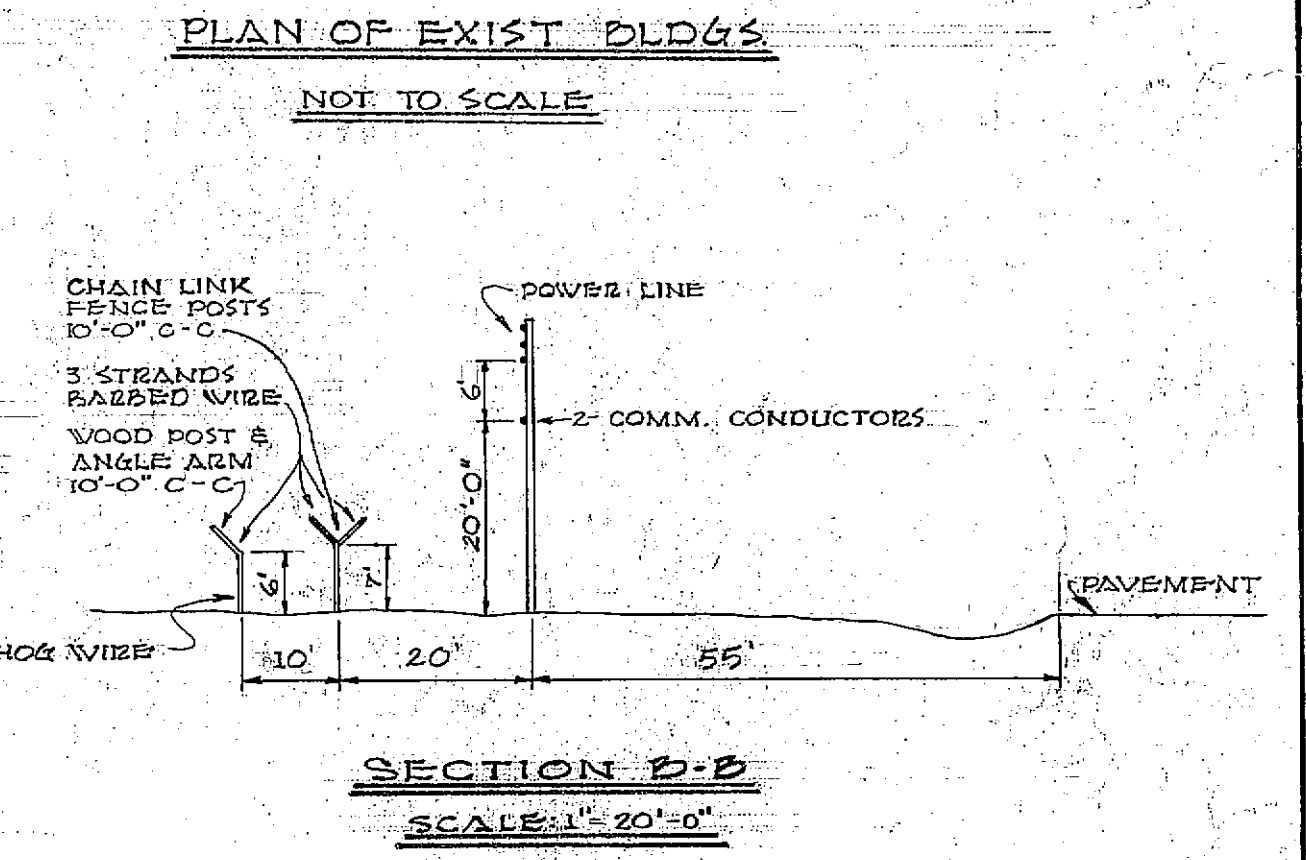


SECTION B-B
SCALE: 1"=20'-0"

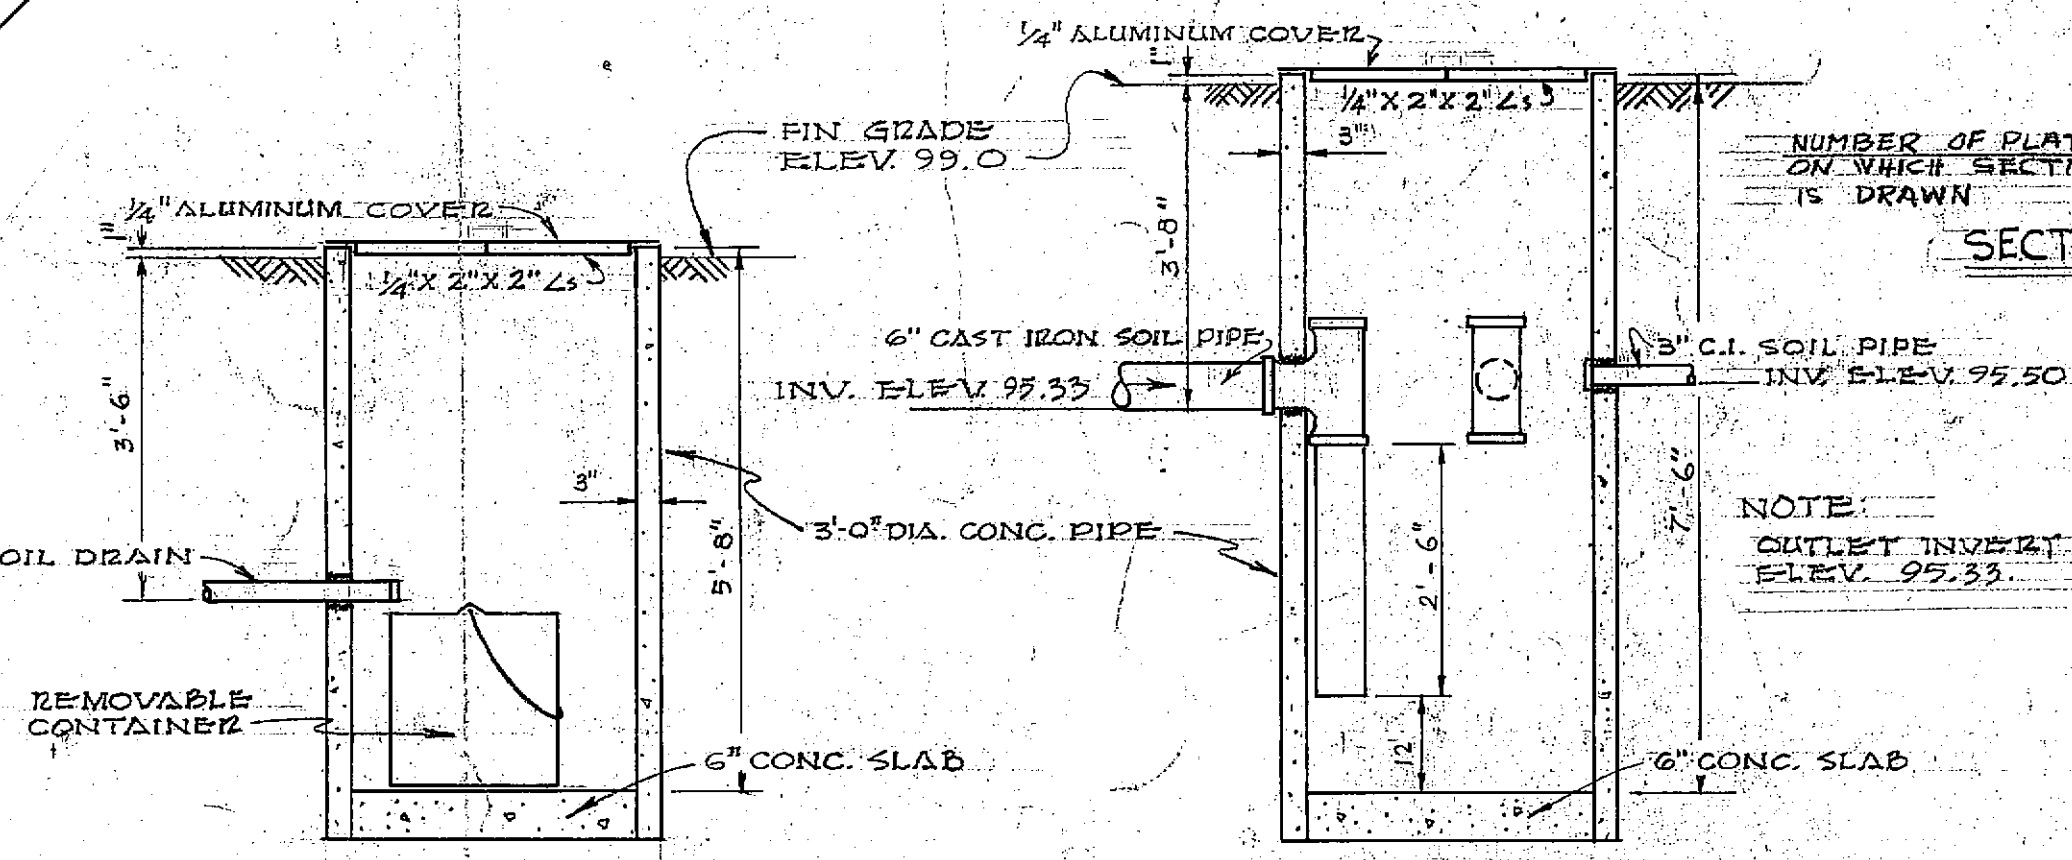

WASTE OIL MANHOLE

OIL SEPARATOR MANHOLE

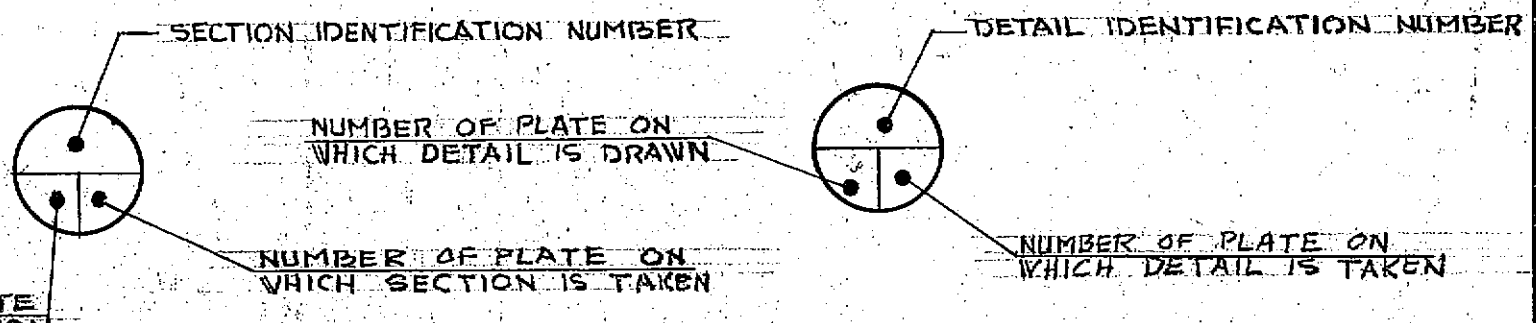

SECTIONS - CROSS REFERENCED **DETAILS - CROSS REFERENCED**

REVISION	DATE	DESCRIPTION	BY
1	14 OCT 64	REVISED AS BUILT	JES
KIRTLAND AIR FORCE BASE, ALBUQUERQUE, NEW MEXICO			
MOD. & REL. BLDGS. 621, 622, & 624			
LOCATION, SITE, PLOT & GRADING PLANS			
KLD 19-2 & KLD 64-2			
BASE CIVIL ENGINEER			
DATE 9 OCT 62			
SUBMITTED			
APPROVAL RECOMMENDED			
APPROVED			
DRAWN: NEIL			
FILE NUMBER			
BEO 51/63			
SHEET 1 OF 8			
SCALE AS SHOWN			
PLATE NO. 1			